


Tank 1
System

SFTR
WATER SYSTEM
AS-BUILTS

HIGH PLAINS ENGINEERING
CIVIL AND STRUCTURAL ENGINEERING
LAND SURVEYING
228 Park Avenue PO Box 607
Raton, New Mexico 87740
(505) 445-5676

DATE: May 21, 2000 JOB NO.: 2649
DR: rh Folsoft 806/351-0727 bhil@comonline.com

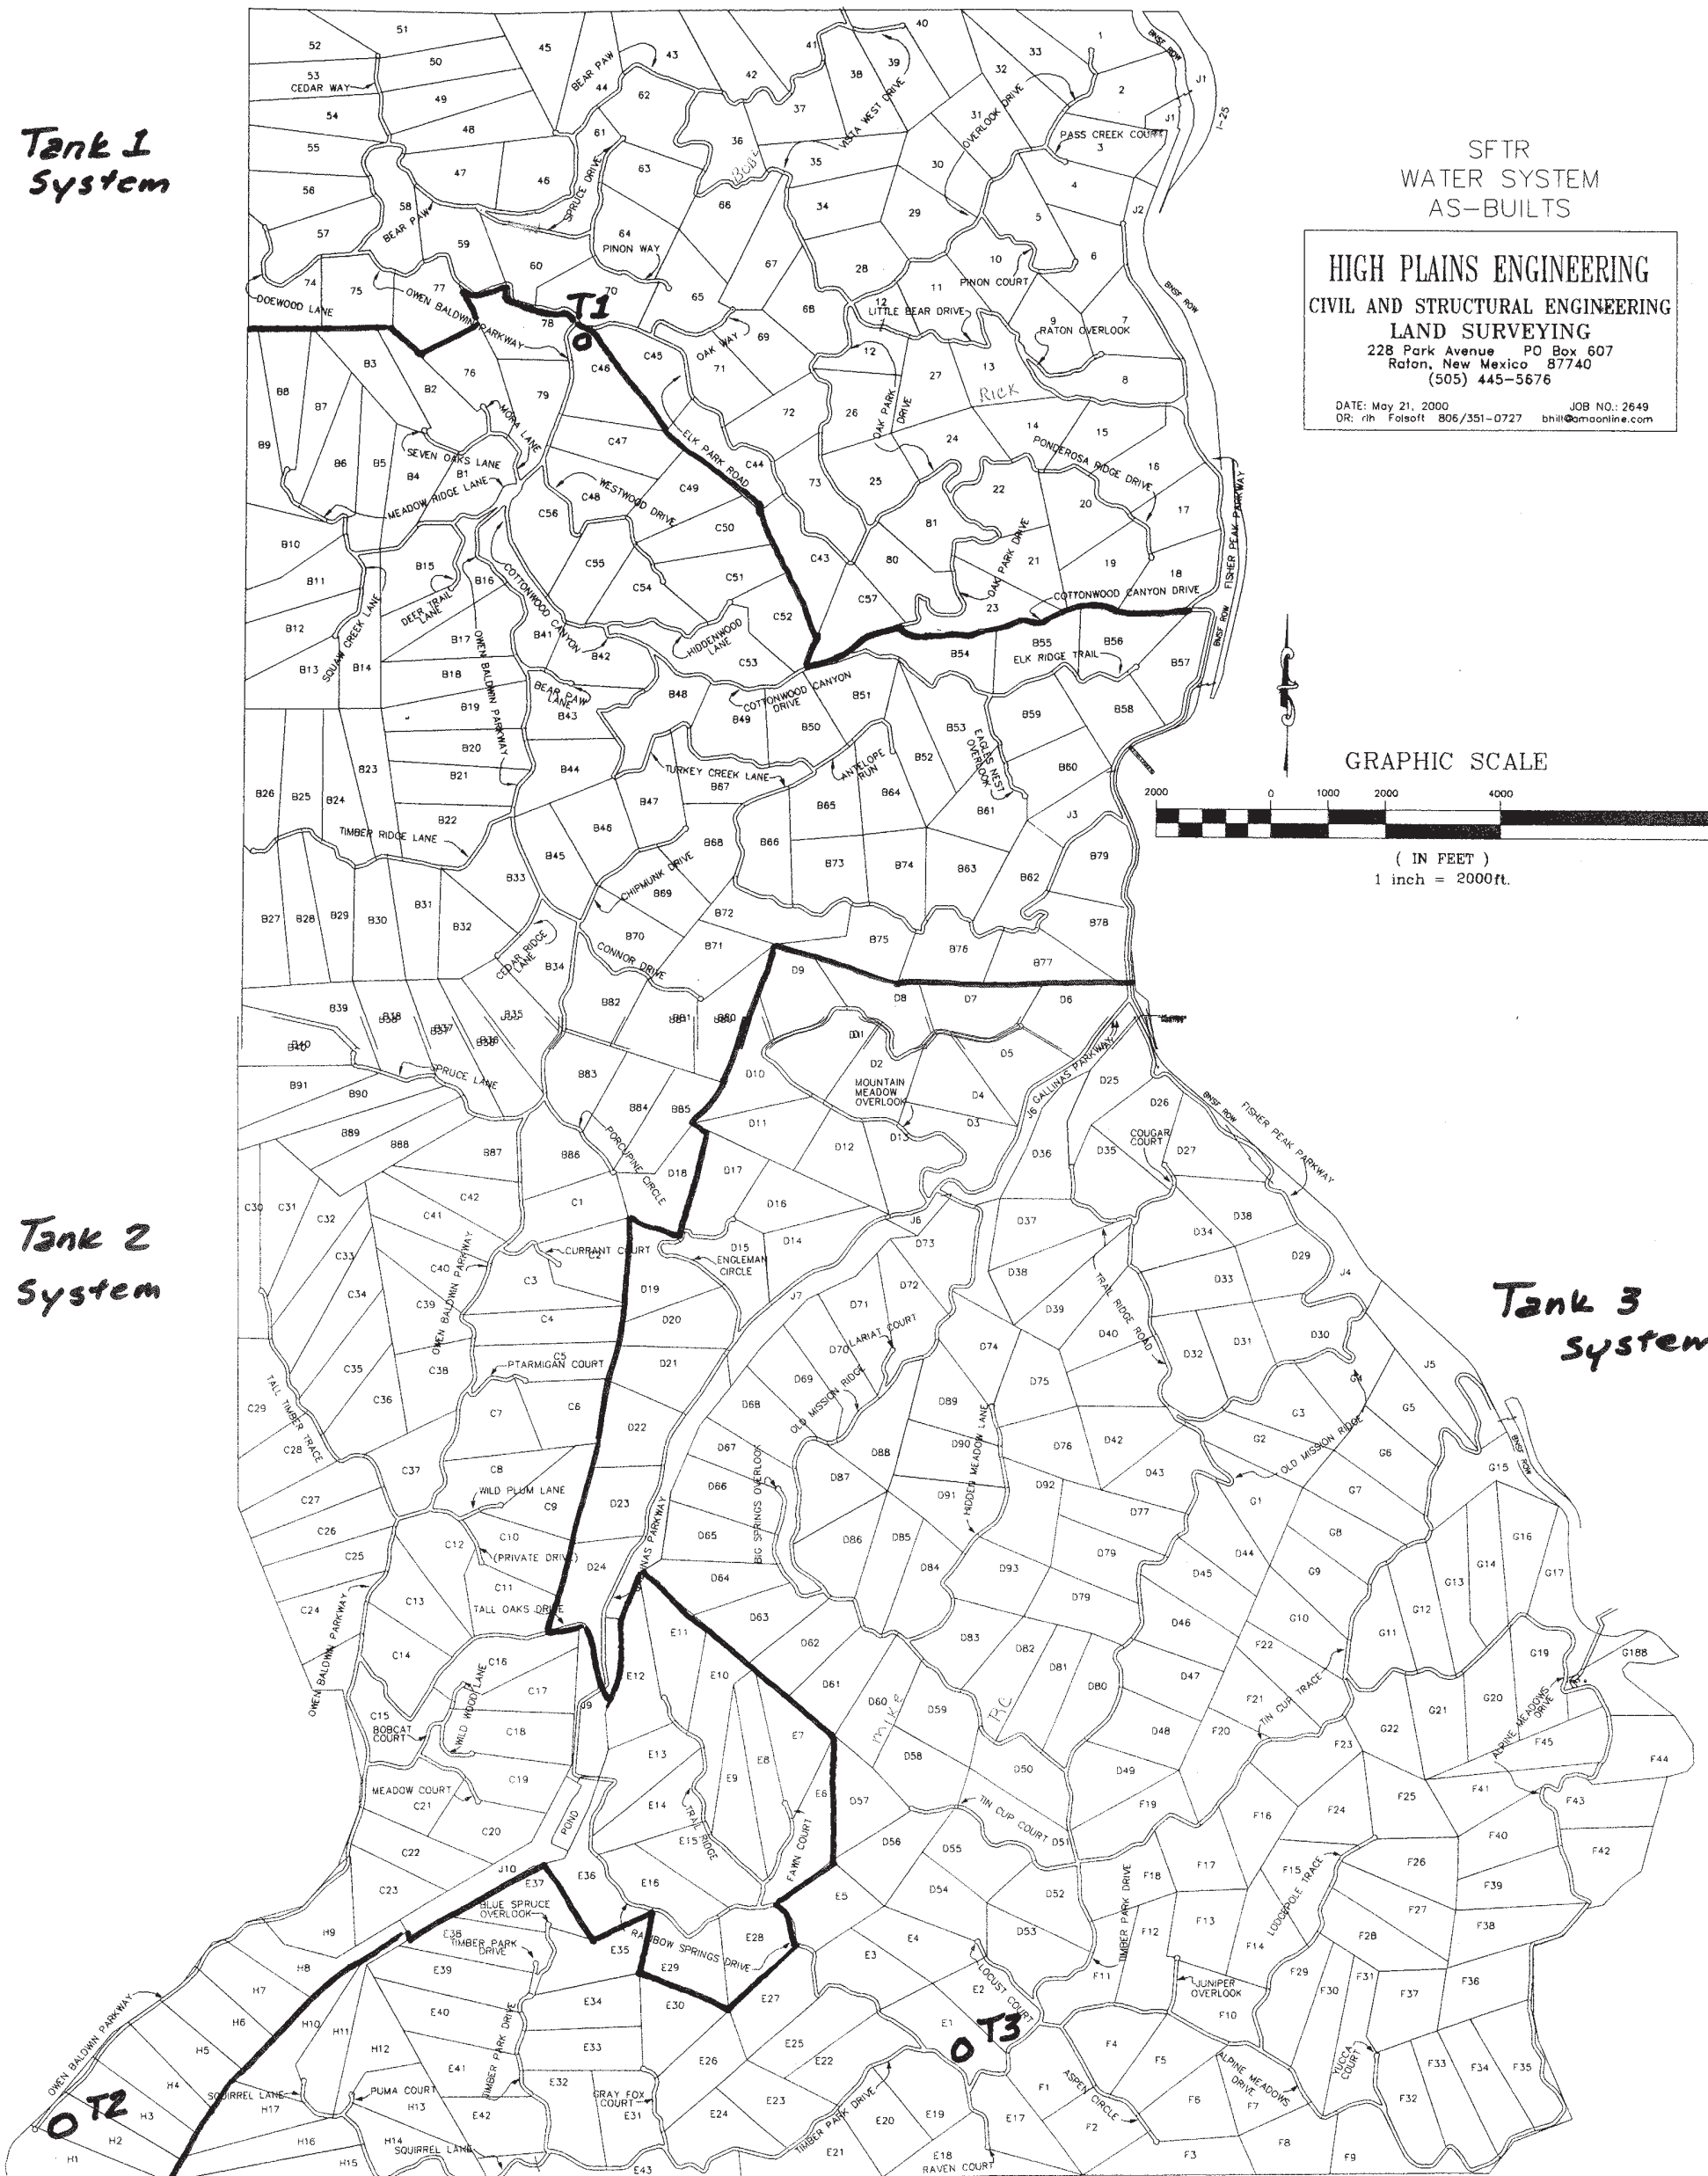

GRAPHIC SCALE



(IN FEET)
1 inch = 2000ft.

Tank 2
System

Tank 3
System